

LEGEND:

SK2


CLASSROOM


>□ LCD PROJECTOR/SCREEN SEE DET.2/SK-1


(E) QT 200 EXHAUST FAN (E) SUPPLY AIR DIFFUSER (E) RETURN REGISTER

(E)2x4 ELEC, FIXTURE RECESSED

REFLECTED CEILING PLAN Checked: Scale: AS SHOWN Checked: Plot Date: 10.23.2017 Drawing No. F**ilename**:c-vusd grovecen Sheet No.1 of 6

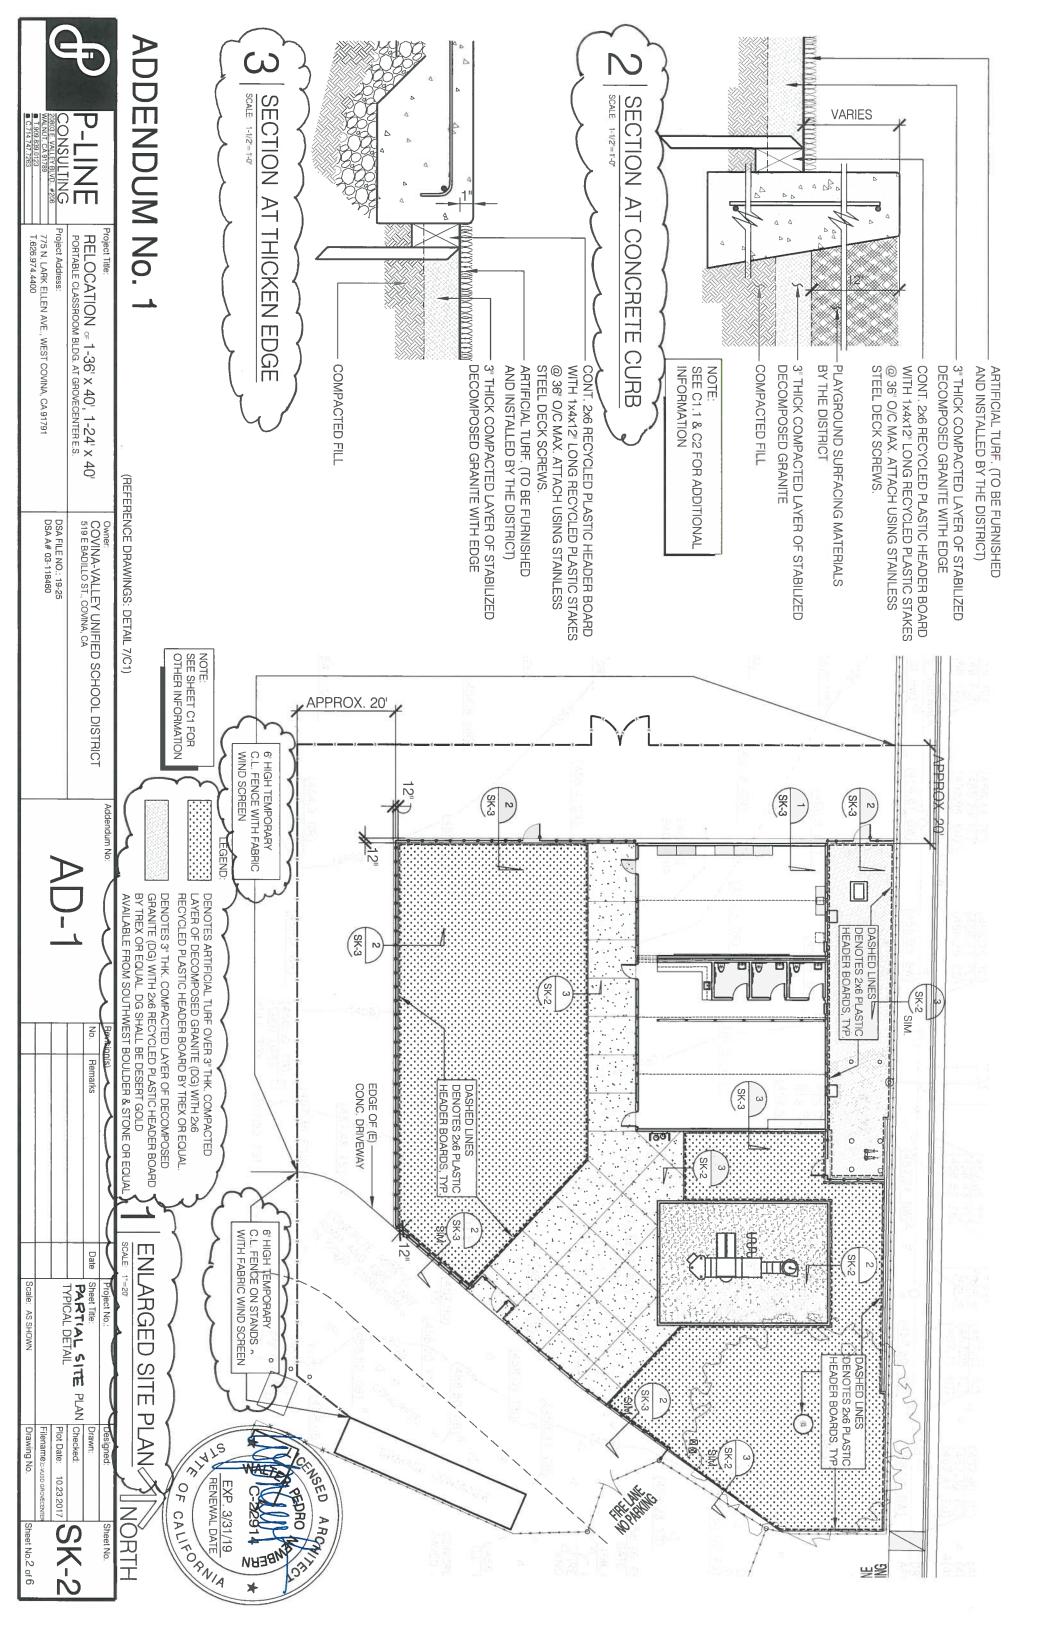

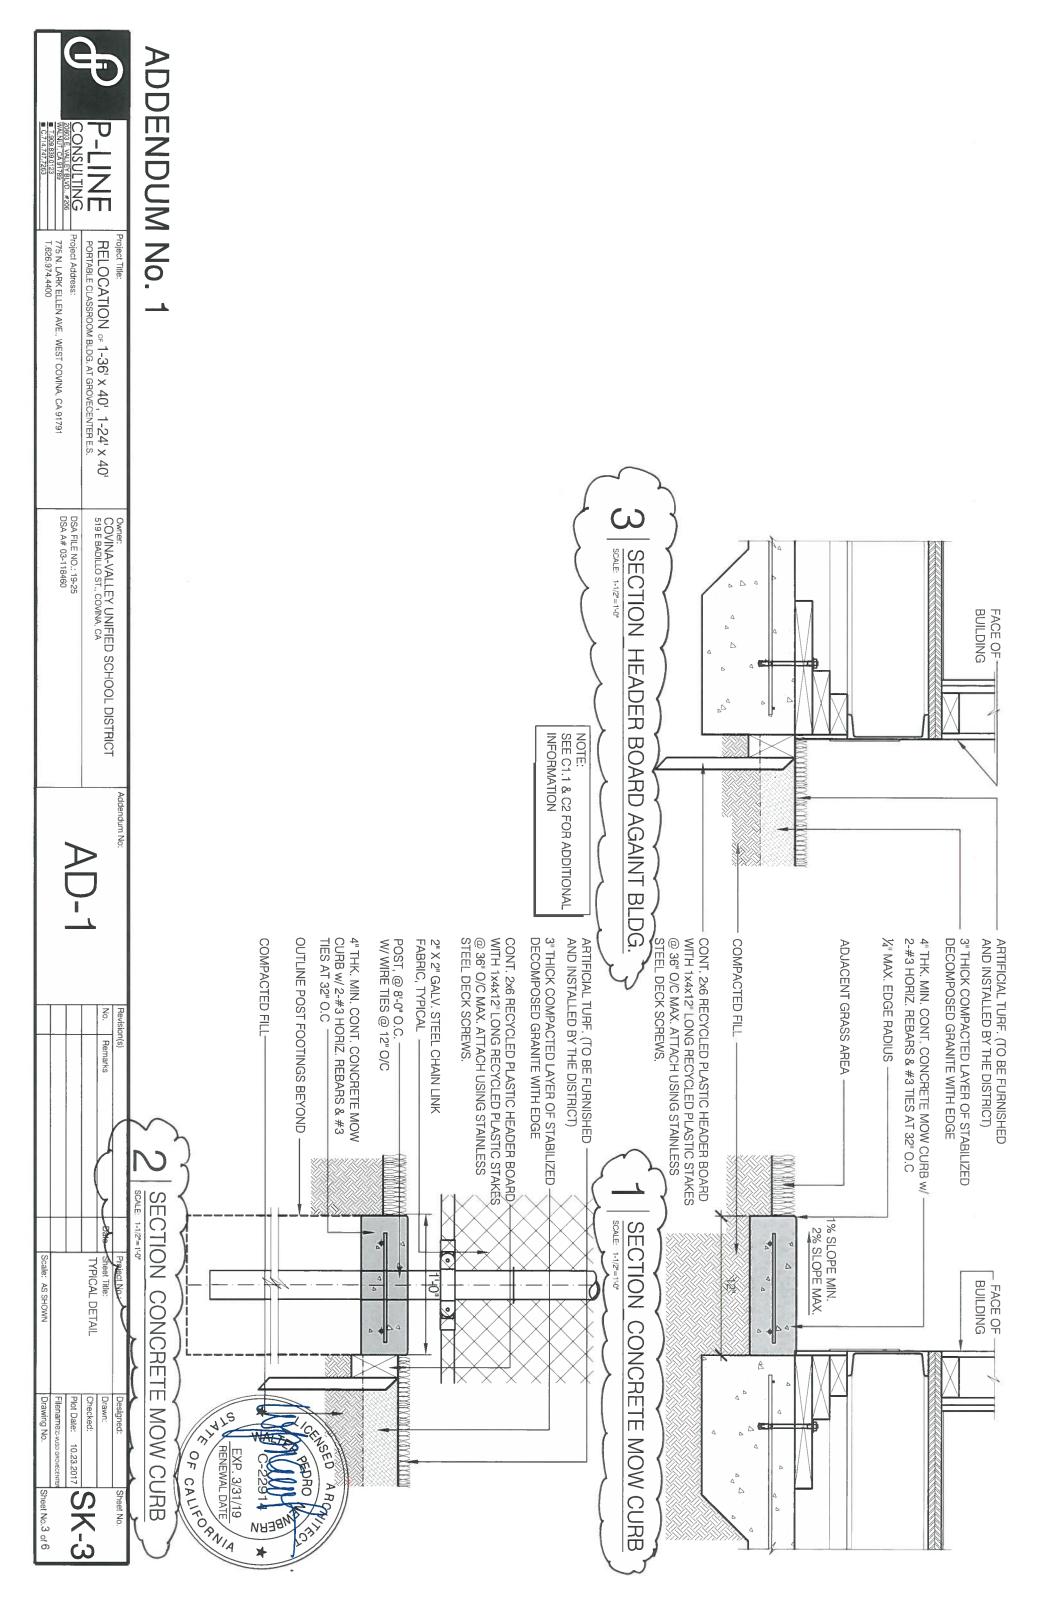


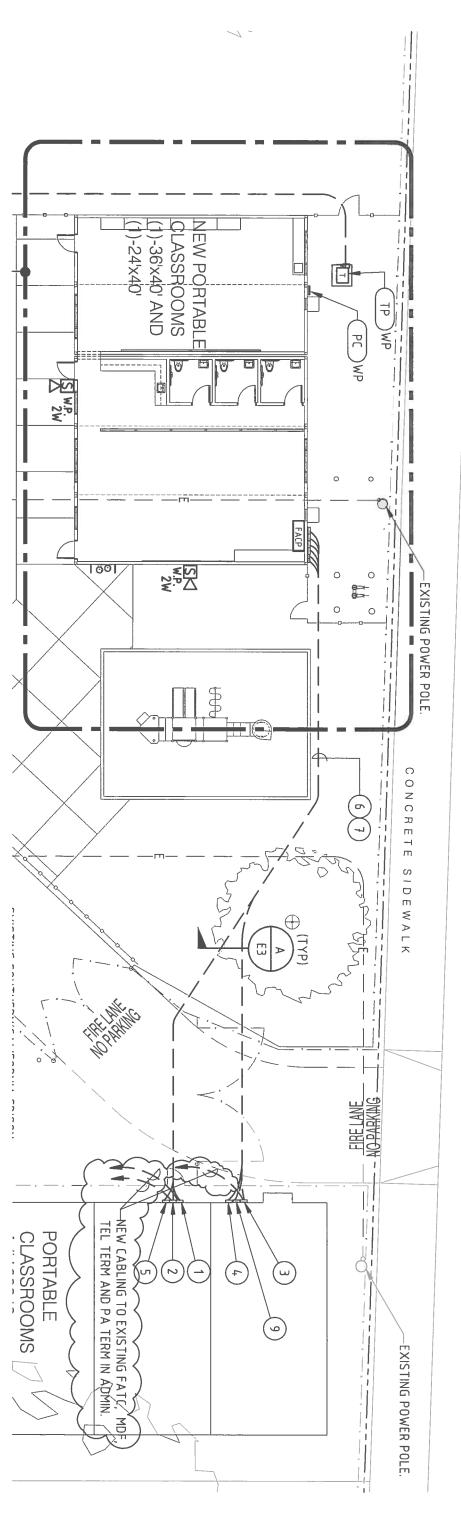

ELECTRICAL SITE PLAN

SCALE: 1/16"=1'-0"



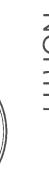



BERN

REFERENCE NOTES:

- EXISTING BUILDING MOUNTED PA/COMMUNICATION PULL BOX.
- EXISTING BUILDING MOUNTED DATA/TELEPHONE PULL BOX
- (L) (w) EXISTING BUILDING MOUNTED FIRE ALARM PULL BOX

EXISTING BUILDING MOUNTED TV/SECURITY PULL BOX

- EXISTING BUILDING MOUNTED CLOCK PULL BOX.
- JOSIGNAL BOXES ON PORTABLE BULLDING EAST OF FIRE LANE: (1) 2"C. 6-STRAND, SINGLE MODE, UNDERGROUND RATED FIBER OPTIC CABLE TO MATCH EXISTING ON CAMPUS FROM IDF TO MDF IN LIBRARY MEDIA CENTER BLDG VIA ADMIN BLDG (APPROX 960'). PROVIDE LC CONNECTORS MATCHING THE EXISTING IN THE LMC MDF. + (4)TEL UG RATED CABLES TO ADMIN (TELEPHONE).
- C. (2) 3PAIR SPEAKER/COMM CABLES TO M TCH EXISTING TO ADMIN (PA/COMM)
- C. WEST PENN AG3245 TO ADMIN FATC FOR FUTURE CAMPUS INTERFACE (FA) BOVE CABLES SHÂLL MATCH EXISTING ON FIBER CABLE PA/COMM CABLES FA AND BUILDING THROUGH EXISTING RACEWAYS.

 BUILDING AND LMC BUILDING PRIOR TO CON CAMPUS VERIFY TYPES WITH DISTRICT TEL CABLES FROM EAST PORTABLE TO FIELD VERIFY PATHWAYS TO MMENCING WORK.
- SAW CUT AND TRENCH TO ACCOMMODATE NEW UNDERGROUND CONDUITS.
- FURNISH AND INSTALL PRECAST CONCRETE PULL BOX 17"X30"X24" DEEP WITH STEEL BOLT-DOWN TRAFFIC COVER MARKED "POWER". INSTALL ON 12" OF CRUSHED ROCK. BROOKS PRODUCTS #66-PB BODY, 66-12" EXTENSION AND 66-PB STEEL
- EXISTING BUILDING MOUNTED SPARE PULL BOX

REF: E2

		No.	Revision(s)
		Remarks	on(s)
		Date	
SITE PLAN AND	PARTIAL ELECTRICAL	Sheet Title:	Project No.:
Plot Date: 10.23.2017	Checked:	Drawn:	Designed:
- NO -	コロロト		Sheet No.
	TES	TES.	Remarks Date PARTIAL ELECTRICAL SITE PLAN AND REFERENCE NOTES

P-LINE


ADDENDUM No.


RENEWAL DATE OF CALLED

775 N. LARK ELLEN AVE., WEST COVINA, CA 91791 T.626.974.4400

²roject Address: RELOCATION of 1-36' \times 40', 1-24' \times 40' Portable classroom bldg. at grovecenter e.s.

DSA FILE NO.: 19-25 DSA A# 03-118460 Owner:
COVINA-VALLEY UNIFIED SCHOOL DISTRICT
519 E BADILLO ST., COVINA, CA

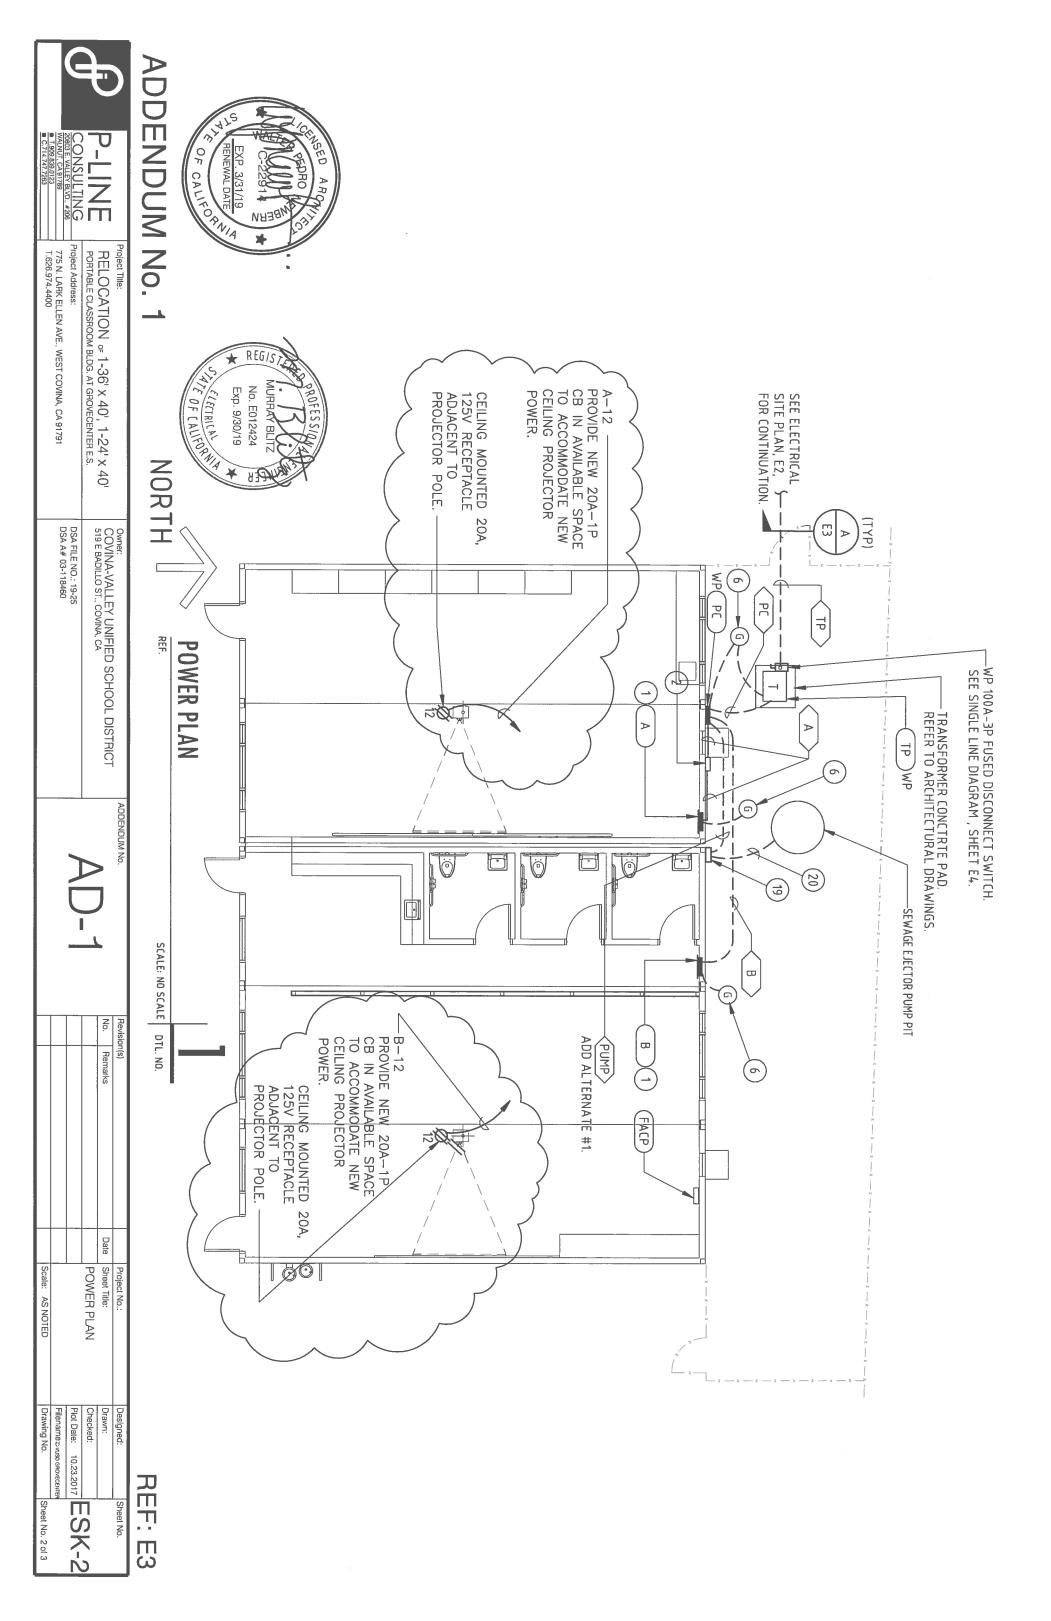

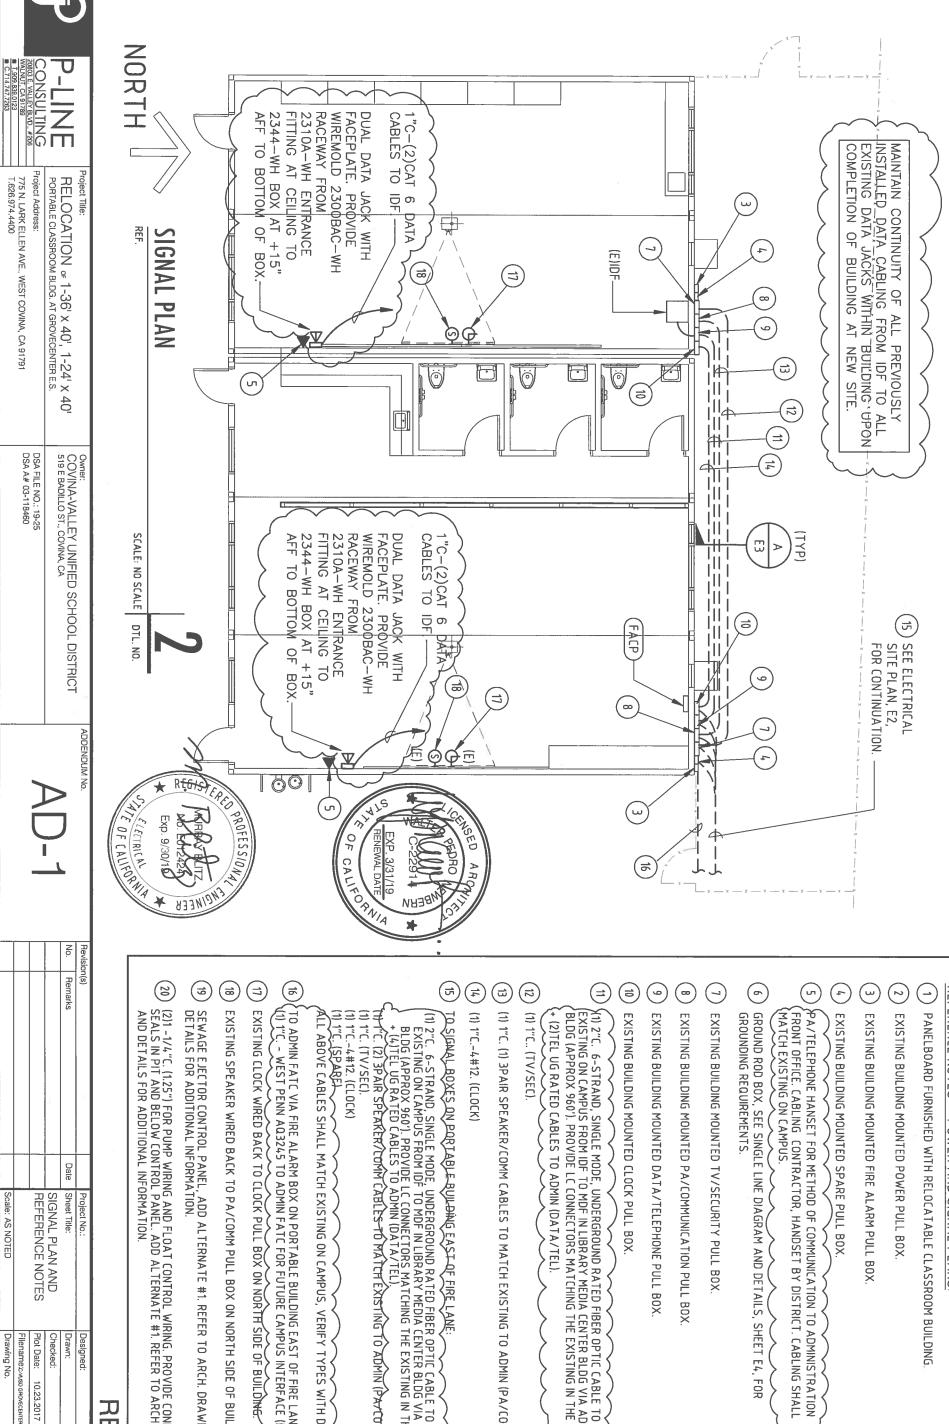

REFERENCE NOTES POWER AND SIGNAL PLANS:

- IED WITH RELOCATABLE CLASSROOM BUILDING

- EXISTING BUILDING MOUNTED SPARE PULL BOX
- PA/TELEPHONE HANSET FOR METHOD OF COMMUNICATION TO ADMINISTRATION
- SINGLE LINE DIAGRAM AND DETAILS, SHEET E4, FOR
- EXISTING BUILDING MOUNTED TV/SECURITY PULL BOX
- EXISTING BUILDING MOUNTED PA/COMMUNICATION PULL BOX.
- EXISTING BUILDING MOUNTED DATA/TELEPHONE PULL BOX
- EXISTING BUILDING MOUNTED CLOCK PULL BOX
- \(\)(1) 2"C. 6-STRAND, SINGLE MODE, UNDERGROUND RATED FIBER OPTIC CABLE TO MATCH\)\\(\)(EXISTING ON CAMPUS FROM IDF TO MDF IN LIBRARY MEDIA CENTER BLDG VIA ADMIN\)\(\)(BLDG (APPROX 960'). PROVIDE LC CONNECTORS MATCHING THE EXISTING IN THE LMC MDF. (2) TEL UG RATED CABLES TO ADMIN (DATA/TEL).
- KER/COMM CABLES TO MATCH EXISTING TO ADMIN (PA/COMM)
- NGLE MODE, UNDERGROUND RATED FIBER OPTIC CABLE TO MATCH
 US FROM IDF TO MDF IN LIBRARY MEDIA CENTER BLDG VIA ADMIN
 1). PROVIDE LC CONNECTORS MATCHING THE EXISTING IN THE LMC MDF/
 CABLES TO ADMIN (DATA/TEL) (ER/LOMM CABLES TO MATCH EXISTING TO ADMIN (PA/COMM)
- IALL MATCH EXISTING ON CAMPUS, VERIFY TYPES WITH DISTRICT.
- TO ADMIN FATC VIA FIRE ALARM BOX ON PORTABLE BUILDING EAST OF FIRE LANE:

 (1) 1"C. WEST PENN AQ3245 TO ADMIN FATC FOR FUTURE CAMPUS INTERFACE (FIRE ALARM)
- EXISTING SPEAKER WIRED BACK TO PA/COMM PULL BOX ON NORTH SIDE OF BUILDING
- TROL PANEL, ADD ALTERNATE #1. REFER TO ARCH. DRAWINGS AND VAL INFORMATION.

OW CONTROL PANEL. ADD ALTERNATE #1. REFER TO ARCH. DRAWINGS TIONAL INFORMATION.

REF: E3

SIGNAL PLAN AND REFERENCE NOTES Filename:c-vuso geovecev Plot Date: Checked: 10.23.2017 ESK-3

8

Sheet No. 3 of 3

Sheet No.